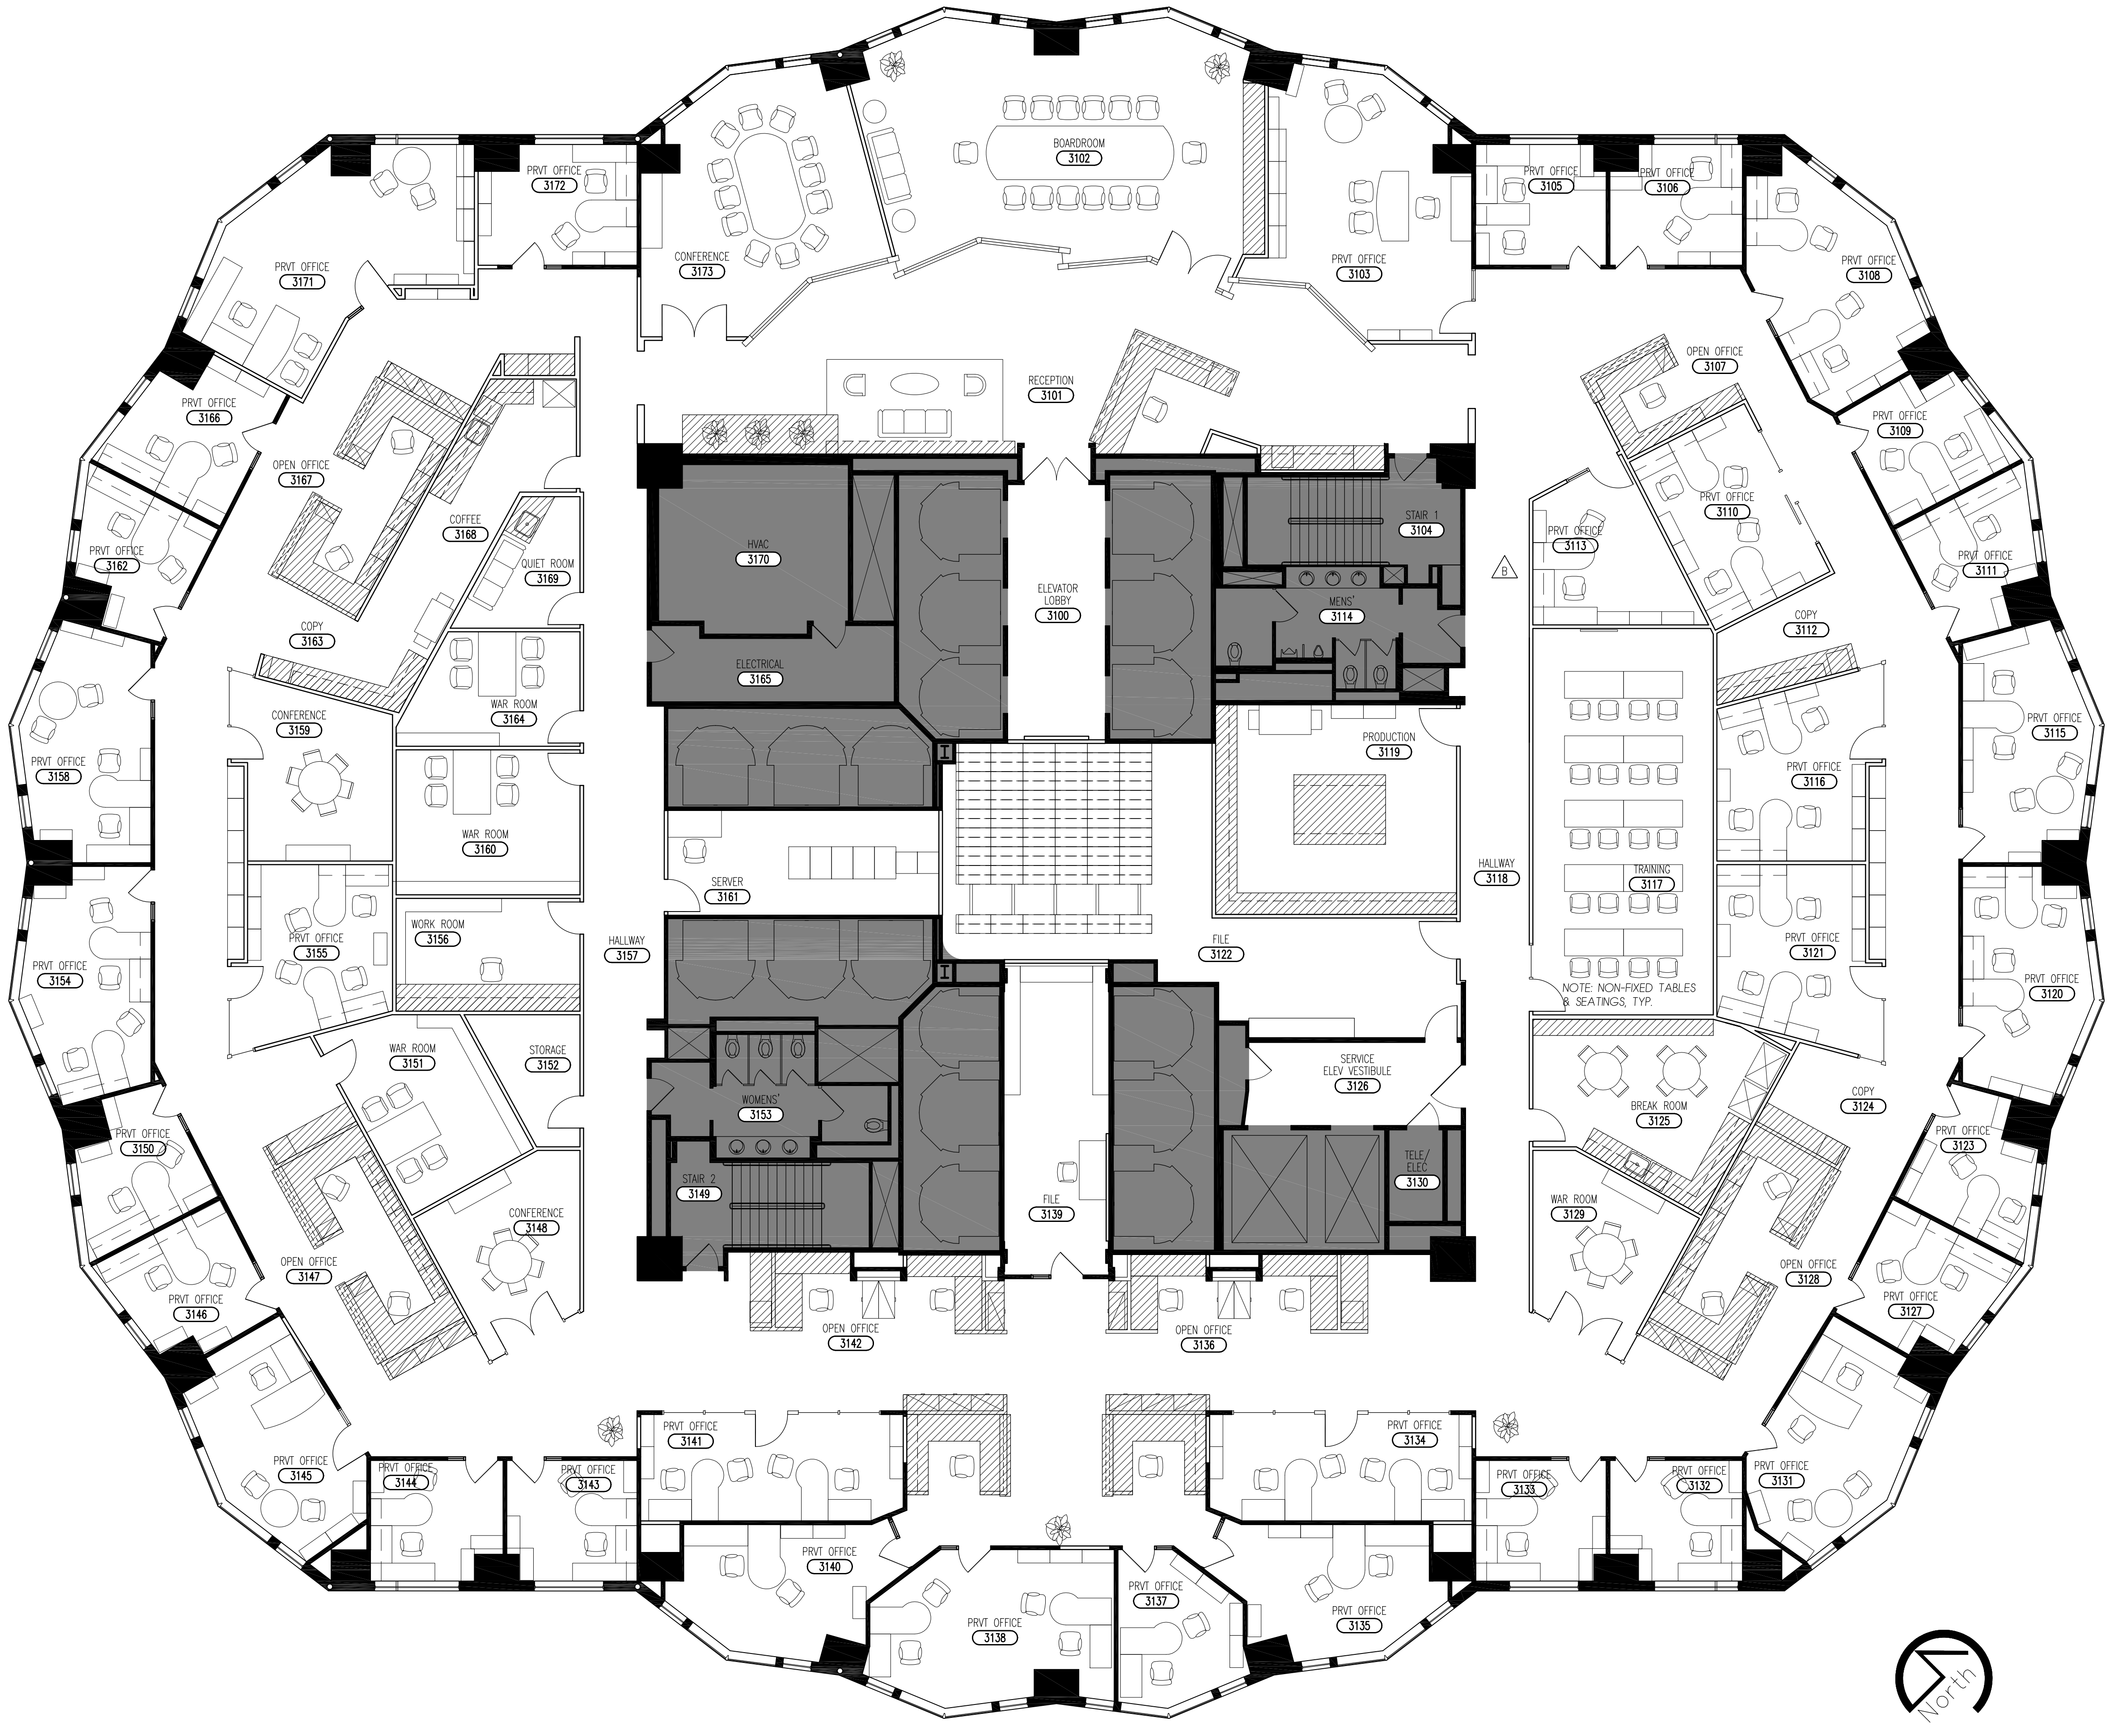

		PARTITION LEGEND	SHEET NOTES - GENERAL	KEYNOTES
		SEE SHEET A0.5	1. REPAIR DAMAGED DRYWALL AND REFINISH ROUGH DRYWALL FINISH AT BUILDING CORE WALLS AS REQUIRED. 2. CAULK (FIRE CAULK AS REQUIRED) ALL PIPE AND CONDUIT PENETRATIONS AT BUILDING CORE WALLS AS REQUIRED. 3. ALL EXISTING WALLS WHERE THE EXISTING WALLCOVERING HAS BEEN REMOVED SHALL RECIEVE A NEW SKIM COAT PRIOR TO FINAL FINISH 4. RE-USE ALL EXISTING DOORS AND HARDWARE WHERE POSSIBLE, REPAIR/REPLACE DAMAGED DOORS AS NECESSARY.	(1) G.C. TO PROVIDE STUB-UP FOR FUTURE PLUMBING.

Wirt Design Group/Inc.
617 W. 7th St. #301, Los Angeles, CA 90017
T 213.239.0990 F 213.239.0991

Cornerstone Research
633 W. 5th Street
31st Floor
Los Angeles, California

Revisions :

	ISSUE FOR LANDLORD REVIEW	02-28-07
B	ADDENDUM B	03-16-07
	ISSUE FOR BID	03-16-07
	ISSUE FOR PLAN CHECK	04-17-07
	ISSUE FOR CONSTRUCTION	05-16-07

Project Director:	.	Scale:	1/8" = 1'-0"
Project Designer:	.	Issue Date:	02-28-07
Drawn By:	.	Issue To Bid:	02-28-07
Approved By:		Plot Date:	02-27-07
Project No:	CRN03.01	File Name:	A10_31.dwg

All drawings and written material appearing herein constitute the original and unpublished work of Wirt Design Group and the same may not be duplicated, used or disclosed without the written consent of Wirt Design Group.

Sheet Title:
Furniture Plan
(For Reference Only)
31st Floor

Sheet No.: A1.0_31

DRAWING FILE: P:\WDG Projects\Cornerstone Research\ACAD\Construction Documents\31st Flr-Cornerstone\Sheets\A1.0_31.dwg May 16, 2007